
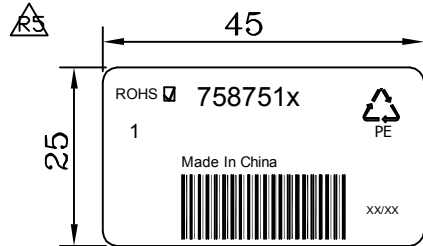


FILE NO:

DESCRIPTION CONTROL			
REV	DESC	DATE	ECN NO.
R4	<del>R4</del>	2012.04.18	
R5	<del>R5</del>	2012.04.23	
R6	colorcode removed	2018-02-01	

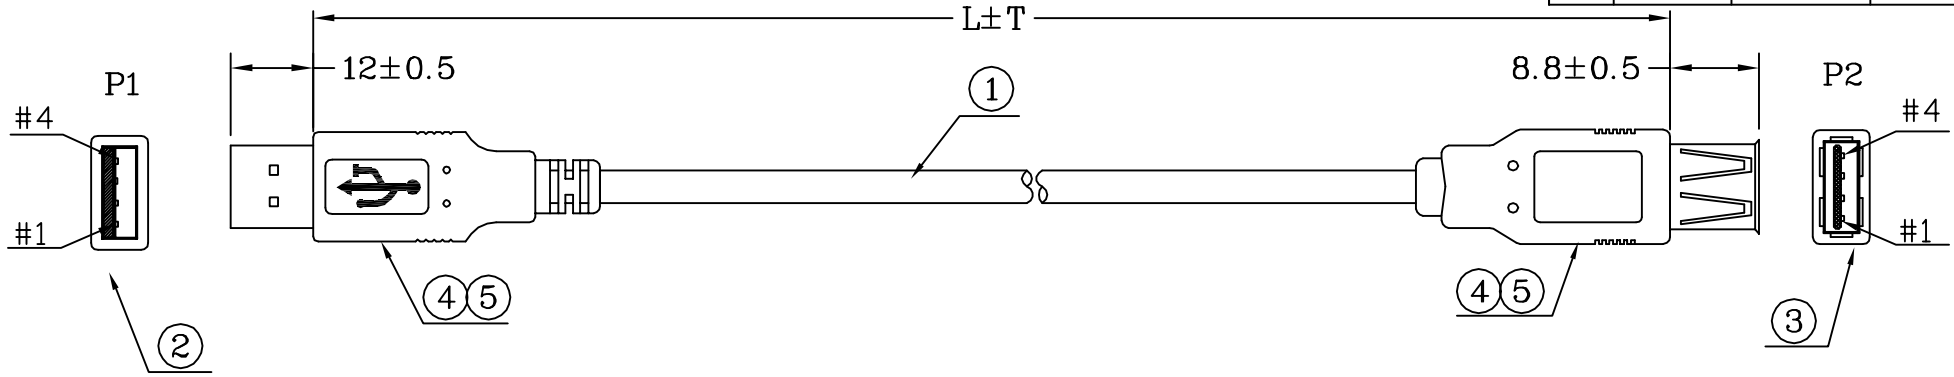

CUSTOMER P/N		L±T	PE BAG:L*W*0.06MM	QTY	QTY
7587510	<del>R4</del>	1000±30	PE BAG:5*6*0.06MM	100.0	A/R
7587513	<del>R4</del>	3000±50	PE BAG:6*8*0.06MM	130.0	A/R

RoHS COMPLIANT



<del>R2</del>	*	LABEL:45*25MM*	1	PCS					
	*	220030000361 TIE-A-BE02	***	MM	INNER MOLDING		USB.A-07		
	*	310000000012 CARTON:46*30*25CM	A/R	PCS	OUTER MOLDING	USB.A-01	USB.A-08		
	*	300010000001 PE BAG:30*28*0.08MM	A/R	PCS					
	*	PE BAG:L*W*0.06MM	1	PCS					
	5	120020000001 PE-5321	1.5	G					
	4	120010000006 PVC-BE02/50	13.6	G					
	3	110082304039 USB-A-S<WH>(PIN 30U*) <del>R3</del>	1	PCS		ITEM: 7587510&7587513		REV R6	
	2	180-041313-C USB-A-P<WH>/L(PIN 30U*) <del>R3</del>	1	SET	DRAWN BY:	SCALE: NONE	DATE: 2018-02-01		
	1	28*1P+24*2C+A+D+B-BE02 -4.8U2725(REV:2.0) <del>R3</del>	L	M	CHECKED BY:	CUSTOMER:C331	PAGE: 1/1		
					APPROVED BY:	CUSTOMER P/N: 75875XX			
NO	TYPE	DESCRIPTION	QTY	UNIT	ALL DIMENSIONS IN mm (UNLESS OTHERWISE SPECIFIED)				